


**NOTES**  
 ALL DIMENSIONS TO BE CHECKED ONSITE.  
 DO NOT SCALE FROM DRAWING.  
 ANY DISCREPANCIES FOUND ON SITE MUST BE REPORTED TO DESIGNER / PROJECT MANAGER.

**REVISIONS**  
 14.11.13 Rev A WEST WING WINGS AMENDED  
 28.11.13 Rev B WEST WING WINGS AMENDED  
 02.12.13 Rev C LOBBY DOOR CHANGED  
 13.03.14 Rev D AS BUILT

© Copyright Open Contracts Ltd  
 ALL PIPED SERVICES TO HAVE I/V AT FINAL CONNECTION TO EACH APPLIANCE

**AS BUILT**

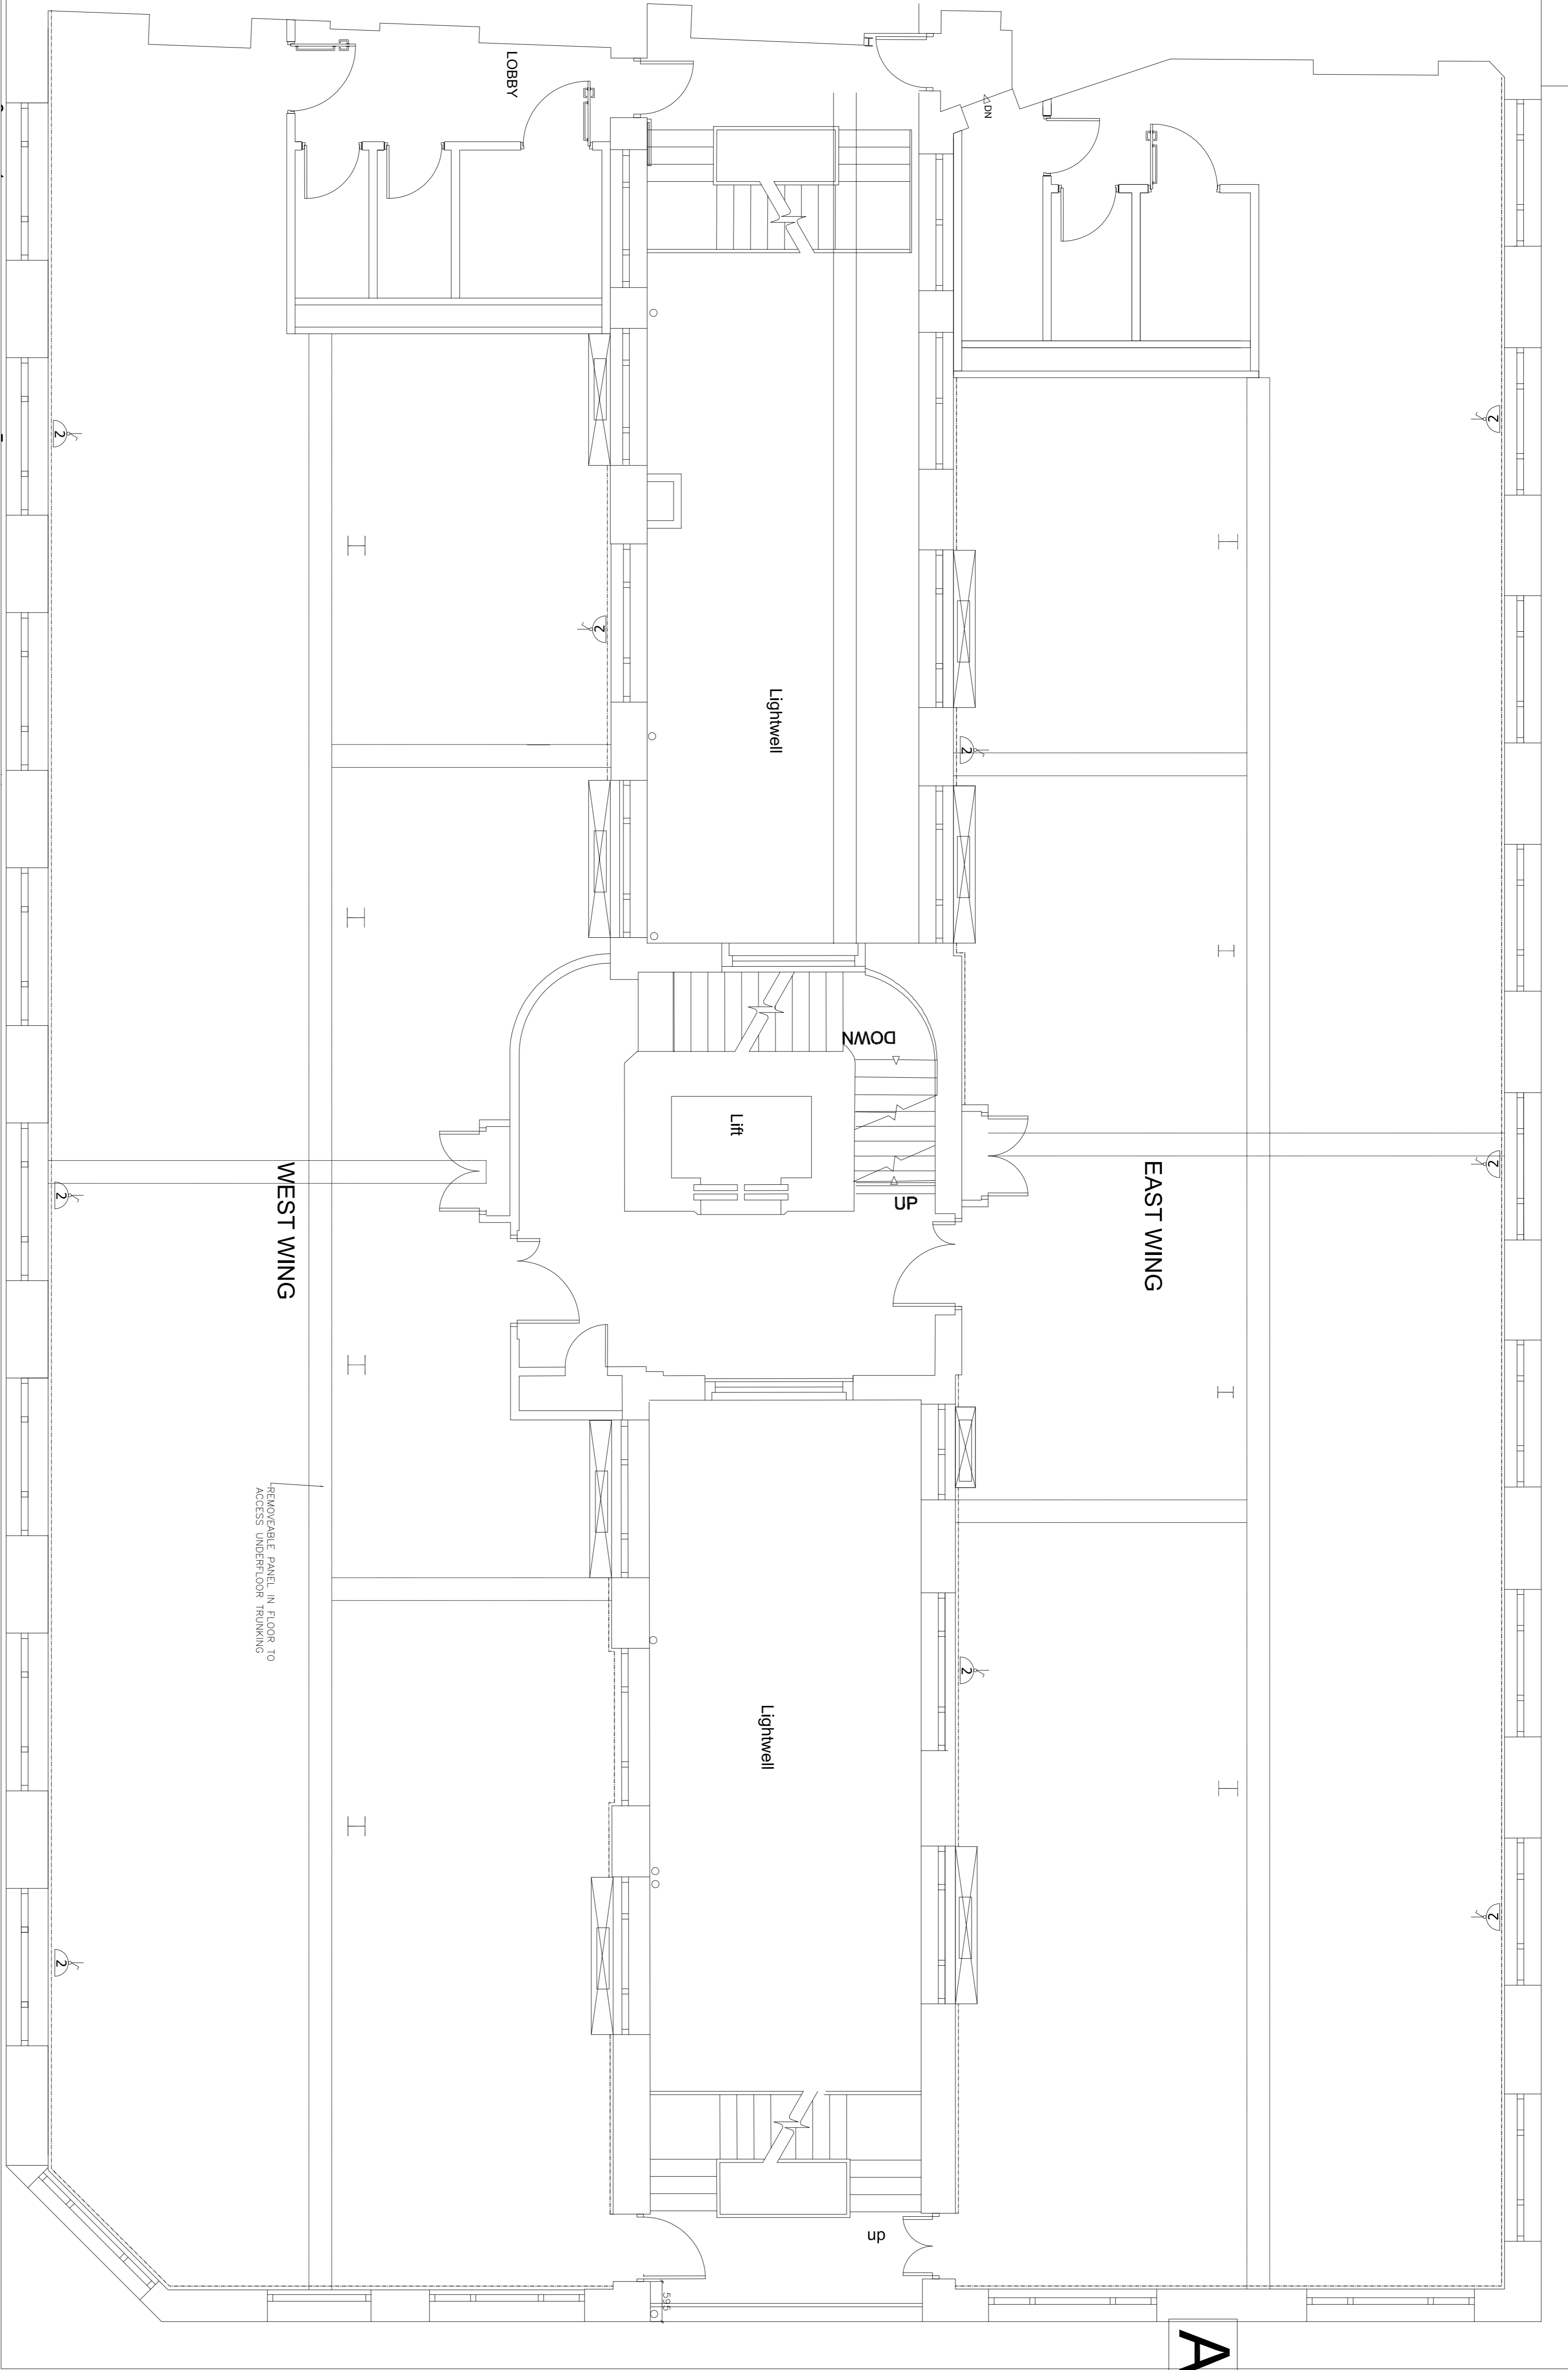

**GENERAL ARRANGEMENT KEY**

	NEW FULL HEIGHT PAINT FINISH DOOR WITH BRUSHED STAINLESS STEEL IRONMONGERY IN PAINTED FRAME. COLOUR TO MATCH 3RD FLOOR		DOUBLE POWER SOCKET		SKIRTING TRUNKING		FLOOR MOUNTED AC UNIT IN CASING 720H
	FLOOR TRUNKING		REMOVABLE PANEL IN FLOOR TO ACCESS UNDERFLOOR TRUNKING				

**Open Contracts Limited**  
 4 Filicroft St  
 London  
 WC2H 8DJ  
 Tel: 020 7240 7711

DESIGNED BY: DW  
 DATE: NOV-13  
 SCALE: 1-50 @ A1  
 CAD BY: DW  
 SIGN OFF:

Drawing No.: FAIR-1-GA  
 Rev D

**CLIENT:**  
 DORRINGTON PROPERTIES

**PROJECT:**  
 1ST FLOOR  
 FAIRFAX HOUSE  
 FULWOOD PLACE  
 LONDON WC1

**TITLE:**  
 PROPOSED GENERAL ARRANGEMENT