
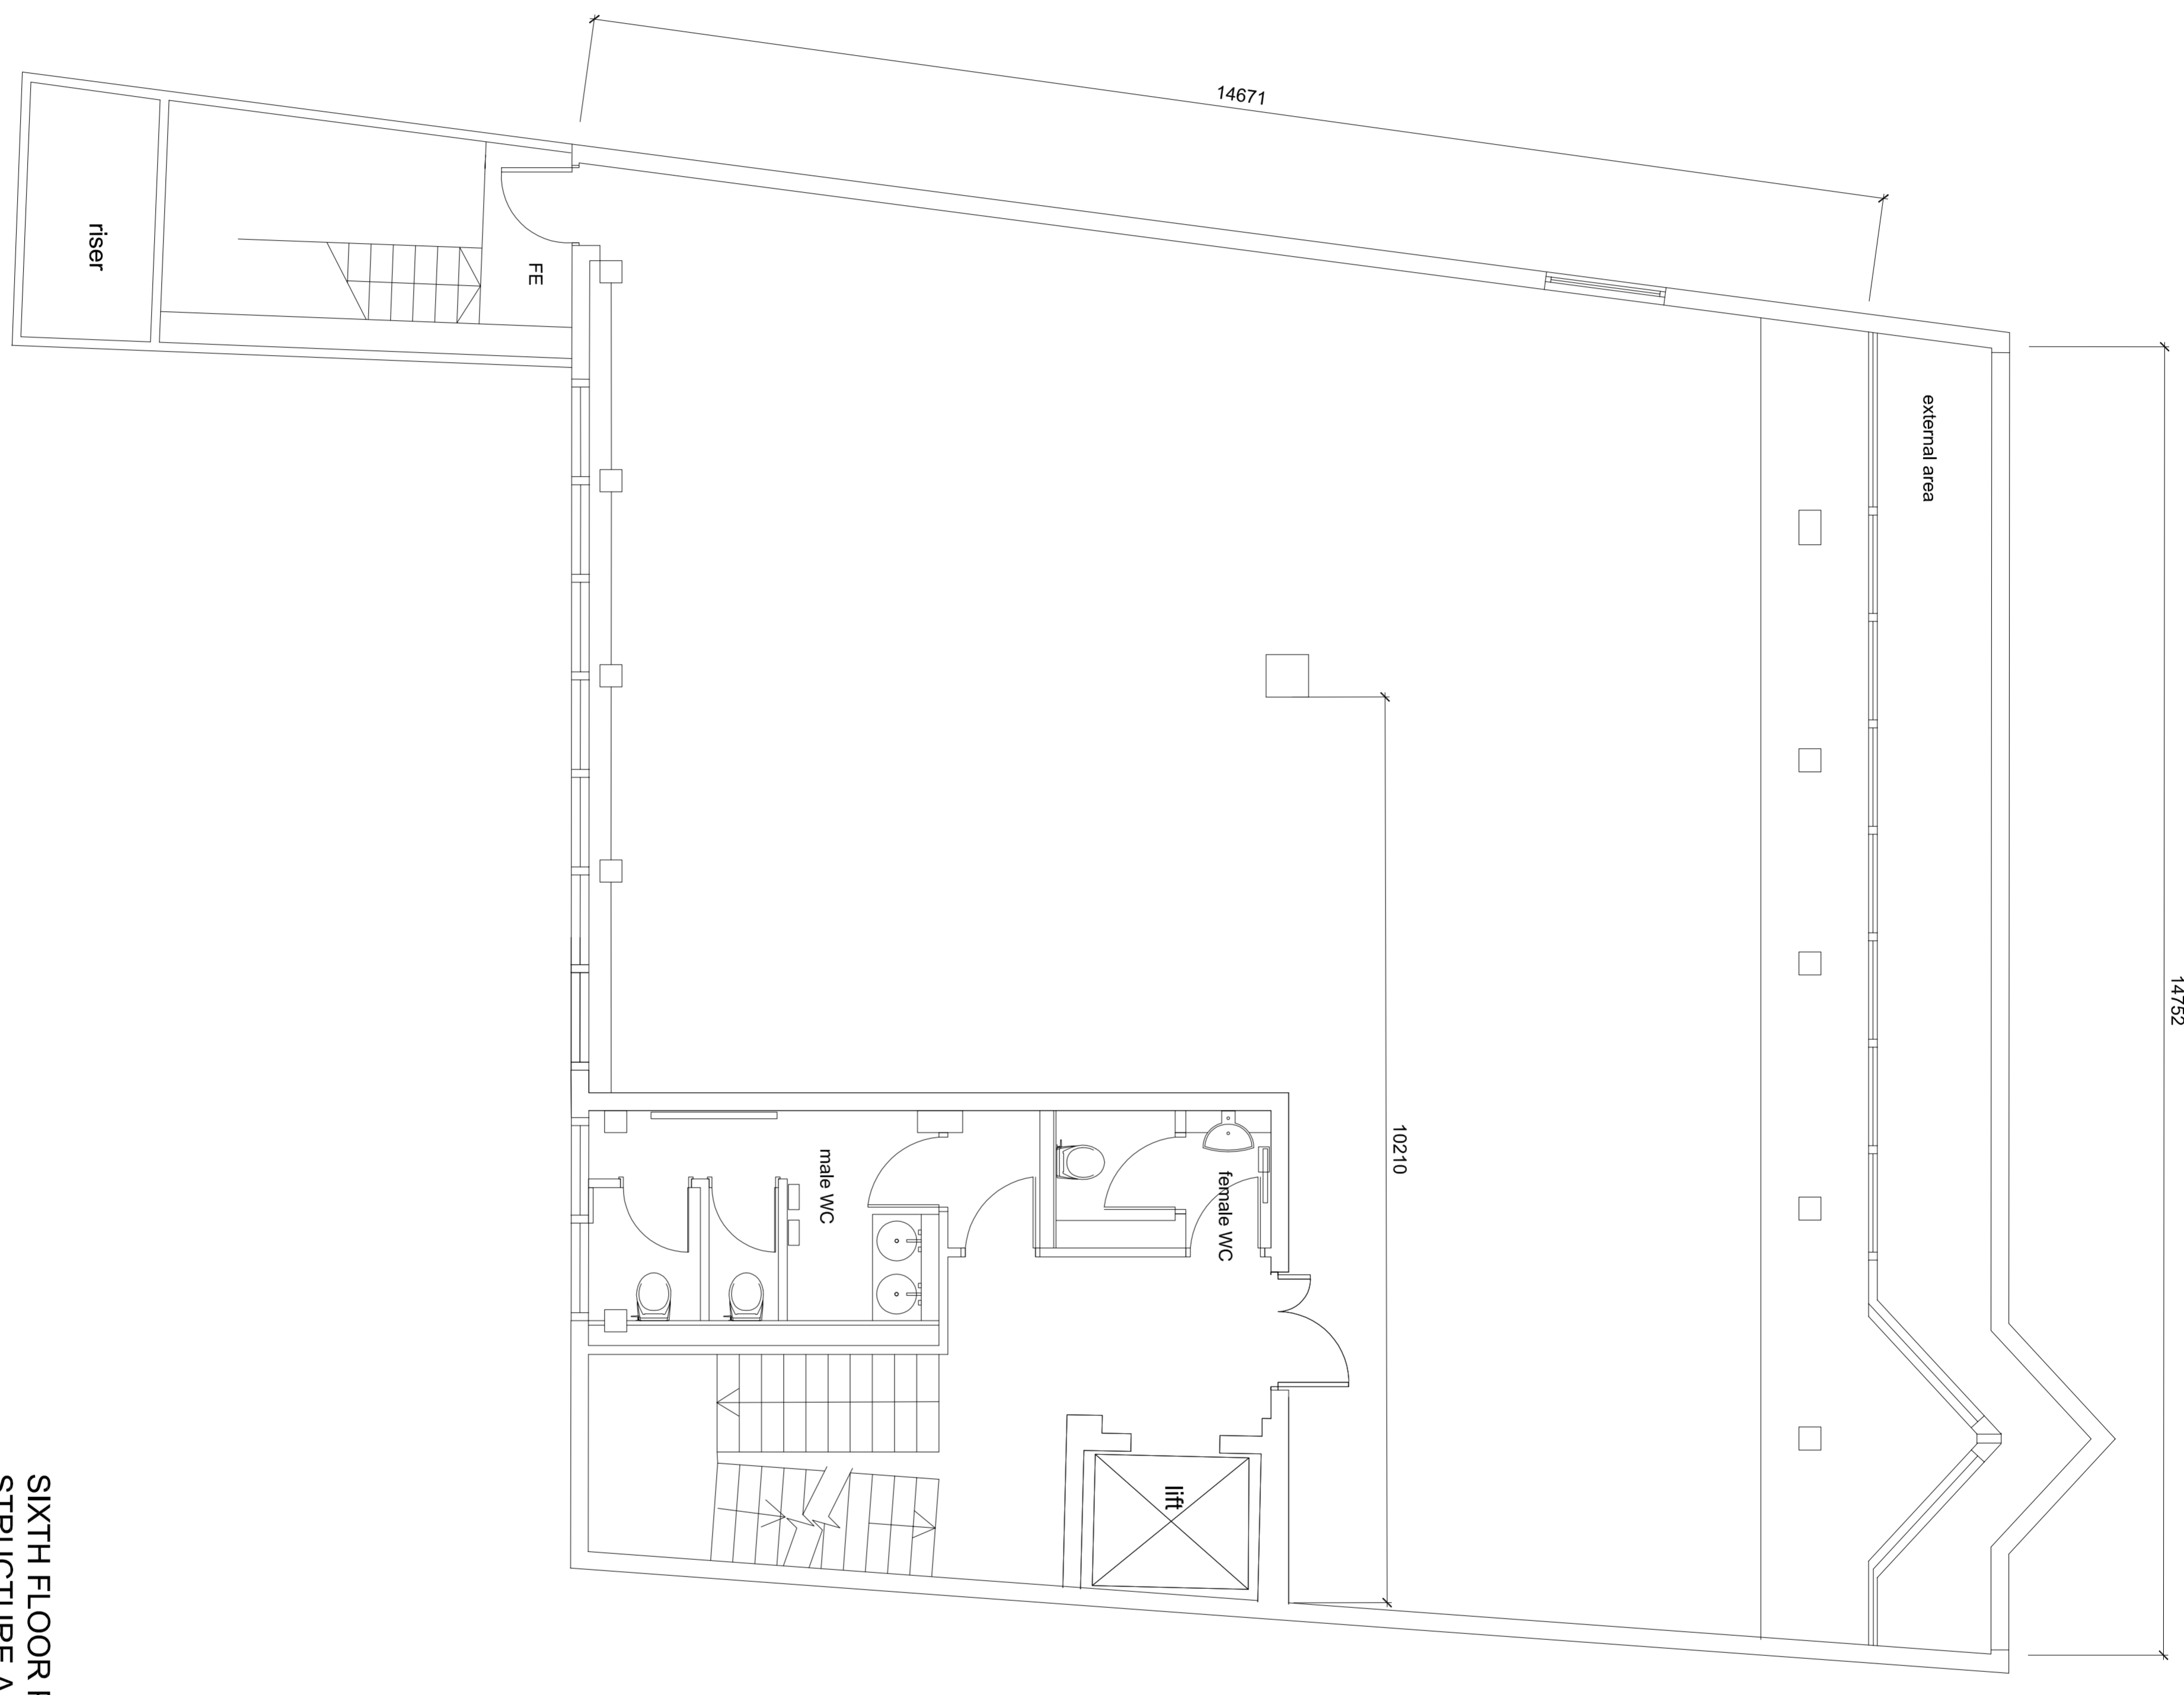


notes  
 Do not scale from drawing  
 Drawing indicates design intent only  
 Any subsequent approvals do not release the  
 architect from liability  
 The contractor is responsible for taking and  
 checking site dimensions  
 Report all conflicts of information to the Architect  
 If in doubt ask

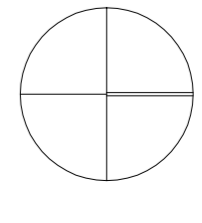

SIXTH FLOOR PLAN AS EXISTING  
 STRUCTURE AND CORE

rev.	description:	date:

rev.	description:	date:

rev.	description:	date:

rev.	description:	date:

client  
**OMNICOM EUROPE**  
 239  
 OLD MARYLEBONE ROAD  
 LONDON

  
 walker + martin  
 architecture + interior design  
 morelands building, 9-15 old st.  
 london ec1 v 9hl  
 t 0171 253 8624 f 0171 253 8625  
 www.walkerandmartin.co.uk

title		date:		drawn by		rev	
SIXTH FLOOR STRUCTURE AND CORE AS EXISTING		21.06.03		CH/KC by		dwg no	
dwg status		scale		xref's		file no	
<input type="checkbox"/> information <input type="checkbox"/> tender <input type="checkbox"/> construction <input checked="" type="checkbox"/> as built		1:50		23005		(1-1) 08	